



Areas for informational and planning purposes only. Contractor to verify all square footages prior to bid.

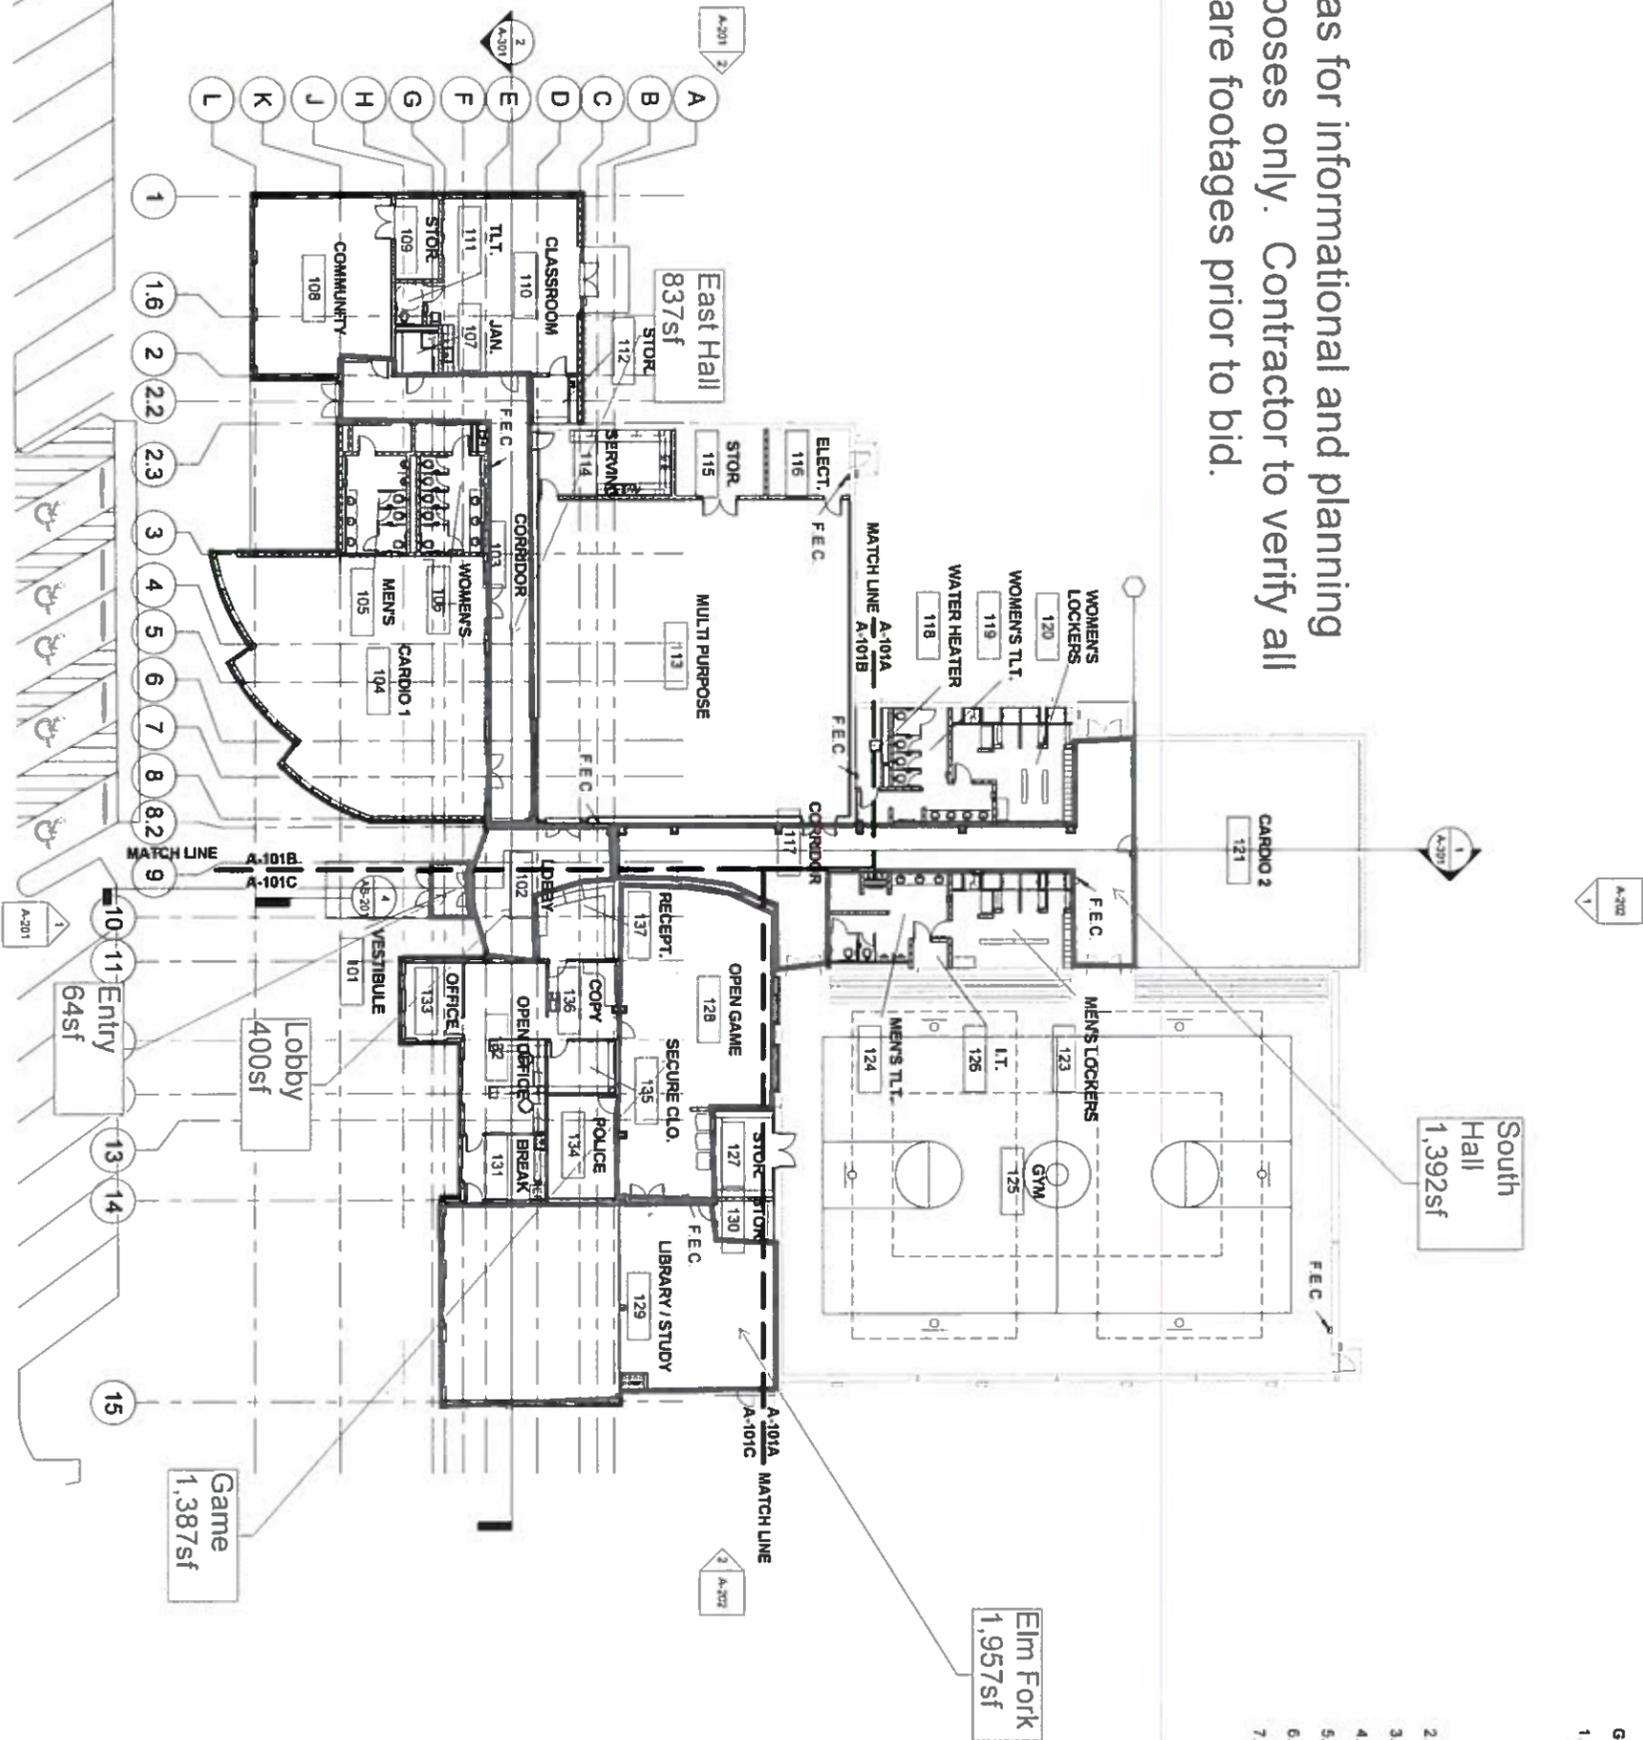

**1 FLOOR PLAN - OVERALL**  
 SCALE 1/16" = 1'-0"

- GENERAL NOTES:**
- 1 THIS PROJECT IS A REMODEL OF AN EXISTING BUILDING AND NOT ALL EXISTING ELEMENTS WERE FIELD VERIFIED. CARE HAS BEEN TAKEN TO PORTRAY EXISTING ELEMENTS AS ACCURATELY AS POSSIBLE. HOWEVER, THE CONTRACTOR SHALL VERIFY ALL EXISTING DIMENSIONS AND CONDITIONS PRIOR TO CONSTRUCTION. ANY SIGNIFICANT DEVIATIONS IN ACTUAL CONDITIONS SHALL BE BROUGHT TO THE ARCHITECT'S IMMEDIATE ATTENTION FOR RESOLUTION. ALL DIMENSIONS ARE FROM FINISH FACE TO FINISH FACE OR GRID LINE UNLESS NOTED OTHERWISE. ALL PARTITIONS ARE TYPE F UNLESS NOTED OTHERWISE.
  - 2 REFER TO PARTITION TYPES LEGEND ON SHEET A-520 FOR PARTITION ASSEMBLIES.
  - 3 REFER TO PLUMBING FOR FIXTURE TYPES AND CONNECTIONS.
  - 4 REFER TO SHEET A-622 FOR GLAZING / STOREFRONT DIMENSIONS & CONFIGURATIONS.
  - 5 PATCH AND REPAIR FLOOR SLAB AT AREAS REMOVED FOR NEW PLUMBING.

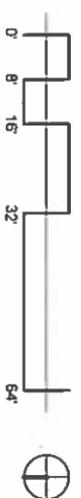

**PBSJ**

6804 BRIDGE POINT PARKWAY, SUITE 200  
 AUSTIN, TX 78730  
 PHONE: 512.227.0840 FAX: 512.227.2433

CONSULTANT

**CORROTONI**

CITY OF CARROLLTON  
 PROJECT MANAGER  
 ANDREW I. COMBS, P.E.  
 1845 E. JACKSON ROAD  
 CARROLLTON, TX 75006  
 972.466.3200

**Crosby Recreation and Community Center Additions & Renovations**

1610 E. Crosby Road  
 Carrollton, TX 75006

ISSUE LOG

No.	Date	Description

SHEET TITLE  
**FLOOR PLAN - OVERALL**

RECORD DRAWINGS

SHEET INFORMATION:

JOB No.	100001548	Sheet Issued:	331/09
Drawn By:	FRK	Sheet Number:	<b>A-101</b>
Checked By:	BWH		
QC/Reviewer:	BWH		
Phase:	CONSTRUCTION		

Areas for informational and planning purposes only.  
Contractor to verify all square footages prior to bid.

North Hall  
1,264sf

South Hall  
1,730sf

Games  
1,115sf

Spin Hall  
418sf

R-Ball Hall  
364sf

Seating  
953sf

Entry  
136sf

Lobby  
2,011sf

Classes Hall  
581sf

